



AS-BUILT

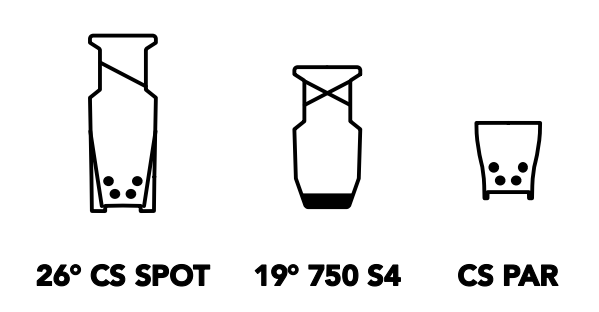

LEGEND
 COLOR: ...
 LENS: ...
 TEMPERATURE: ...
 LAMP: ...
 CHANNEL #: ...

MW LIGHTING
 LD# 10574
 REVISED
 01/20/2025

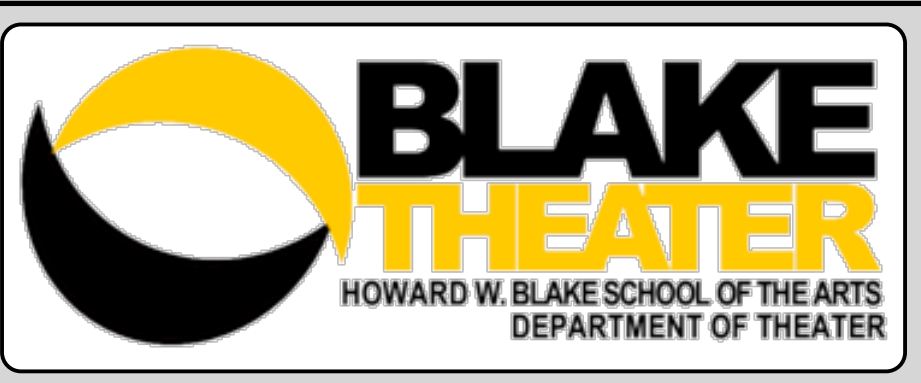

BLACK BOX THEATRE
 HOUSE REPERTORY PLOTS
 GRID HANG
 1/2" = 1' ARCH E

PLATE #
 1
 OF 1